

**SCDHEC OFFICE OF OCEAN AND COASTAL RESOURCE MANAGEMENT
PERMIT APPLICATION PUBLIC NOTICE**

March 21, 2008

Permit Number: OCRM-08-837
Permit ID: 62623

The SCDHEC Office of Ocean and Coastal Resource Management has received an application for a permit for the alteration of a critical area. This application was submitted pursuant to the Coastal Zone Management Act (Act 123) of the 1977 South Carolina General Assembly. The application, in brief, is described as follows:

APPLICANT: Robert J Meadows
C/o Beaufort Surveying, Inc.
1613 Paris Avenue Ste 213
Port Royal SC 29935

LOCATION: On and adjacent to Fripp Canal at 443 Tarpon Boulevard, Fripp Island, Beaufort County, South Carolina.
TMS#: R400-039-000-0039-0000.

WORK: The work as proposed and shown on the attached plans consists of making additions to an existing private dock. Specifically, a 12.5'x12.5' four pile boatlift will be placed to the left of an existing fixed pierhead. The purpose for the dock additions is for the owner's private recreational use.

This public notice is being distributed to all known interested persons and agencies to assist in developing facts on which a decision by OCRM can be based. Comments concerning the proposed work should be submitted in writing, setting forth sufficient detail to furnish a clear understanding of the reasons for support or opposition.

The decision to issue or deny a permit will be based on the individual merits of the application, the policies specified in the South Carolina Coastal Zone Management Act, and the considerations outlined in the State of South Carolina Coastal Zone Management Program. Interested parties who wish to be notified of final permit action must notify OCRM in writing of this request.

To assure review by OCRM, comments regarding this application must be received by OCRM on or before April 5, 2008. For further information please contact the project manager for this activity, Geordie Madlinger at 843-846-9400.

PLEASE REPLY TO:


SCDHEC OFFICE OF OCEAN AND COASTAL RESOURCE MANAGEMENT
104 Parker Drive
Beaufort, South Carolina 29906

Please refer to P/N# OCRM-08-837



G. J. Madlinger, III, Project Manager

DOCK AS-BUILT
PREPARED FOR
ROBERT J. MEADOWS

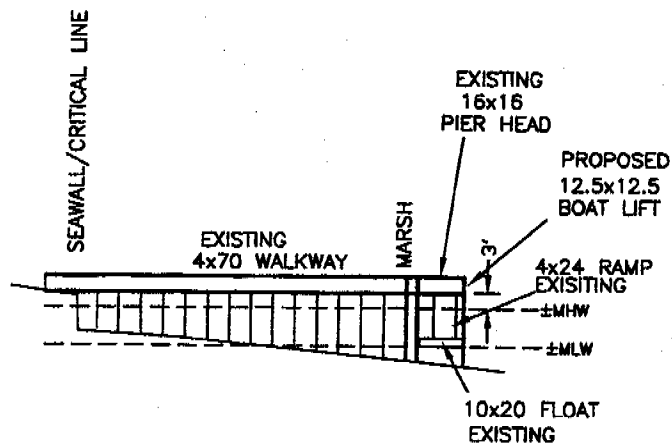

SIDE VIEW
NOT TO SCALE

R400-039-000-0039-0000

0 30' 60' 120' 180'

SCALE 1" = 60'

FEBRUARY 27, 2008
P13669/MMA

David S. Youmans
DAVID S. YOUNANS RLS 9765
BEAUFORT SURVEYING, INC.
1613 PARIS AVENUE
PORT ROYAL, S.C. 29935
PHONE (843) 524-3261

APPLICANT: ROBERT J. MEADOWS
443 TARPON BLVD.

ACTIVITY: DOCK AS-BUILT

OCpm-08-837

LOCATION: FRIPP ISLAND


COUNTY: BEAUFORT

DATE: 02/27/08

ADJACENT PROPERTY OWNERS

ROBERT J. DIBENEDETTO

RICHARD CHRISTIAN

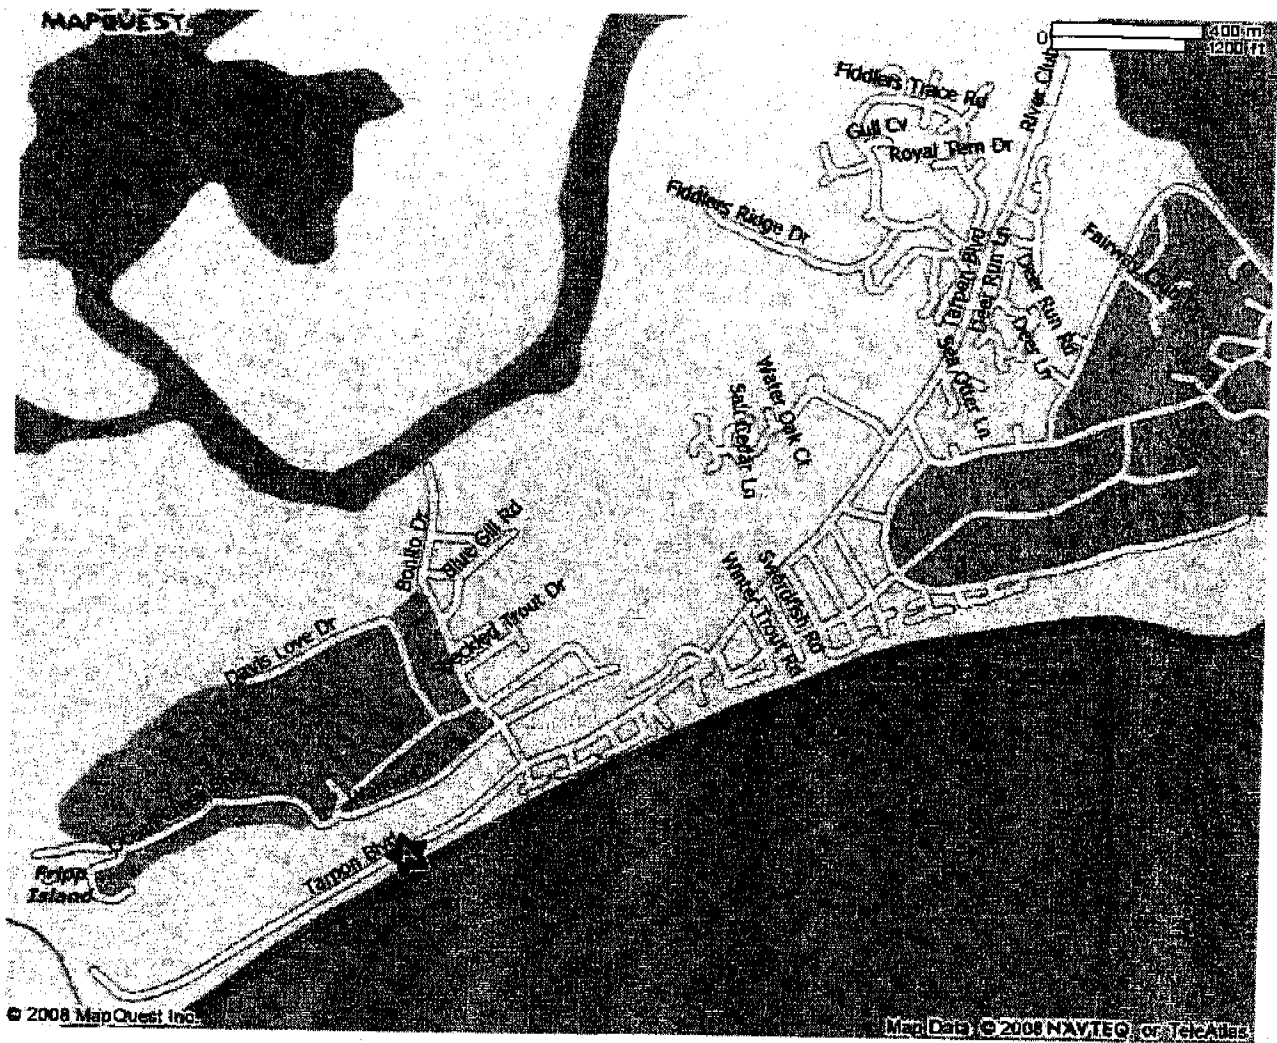

APPLICANT: ROBERT J. MEADOWS
443 TARPON BLVD.

ACTIVITY: DOCK AS-BUILT

Ocrn-08-837

LOCATION: FRIPP ISLAND

COUNTY: BEAUFORT

DATE: 02/27/08

ADJACENT PROPERTY OWNERS

ROBERT J. DIBENEDETTO

RICHARD CHRISTIAN